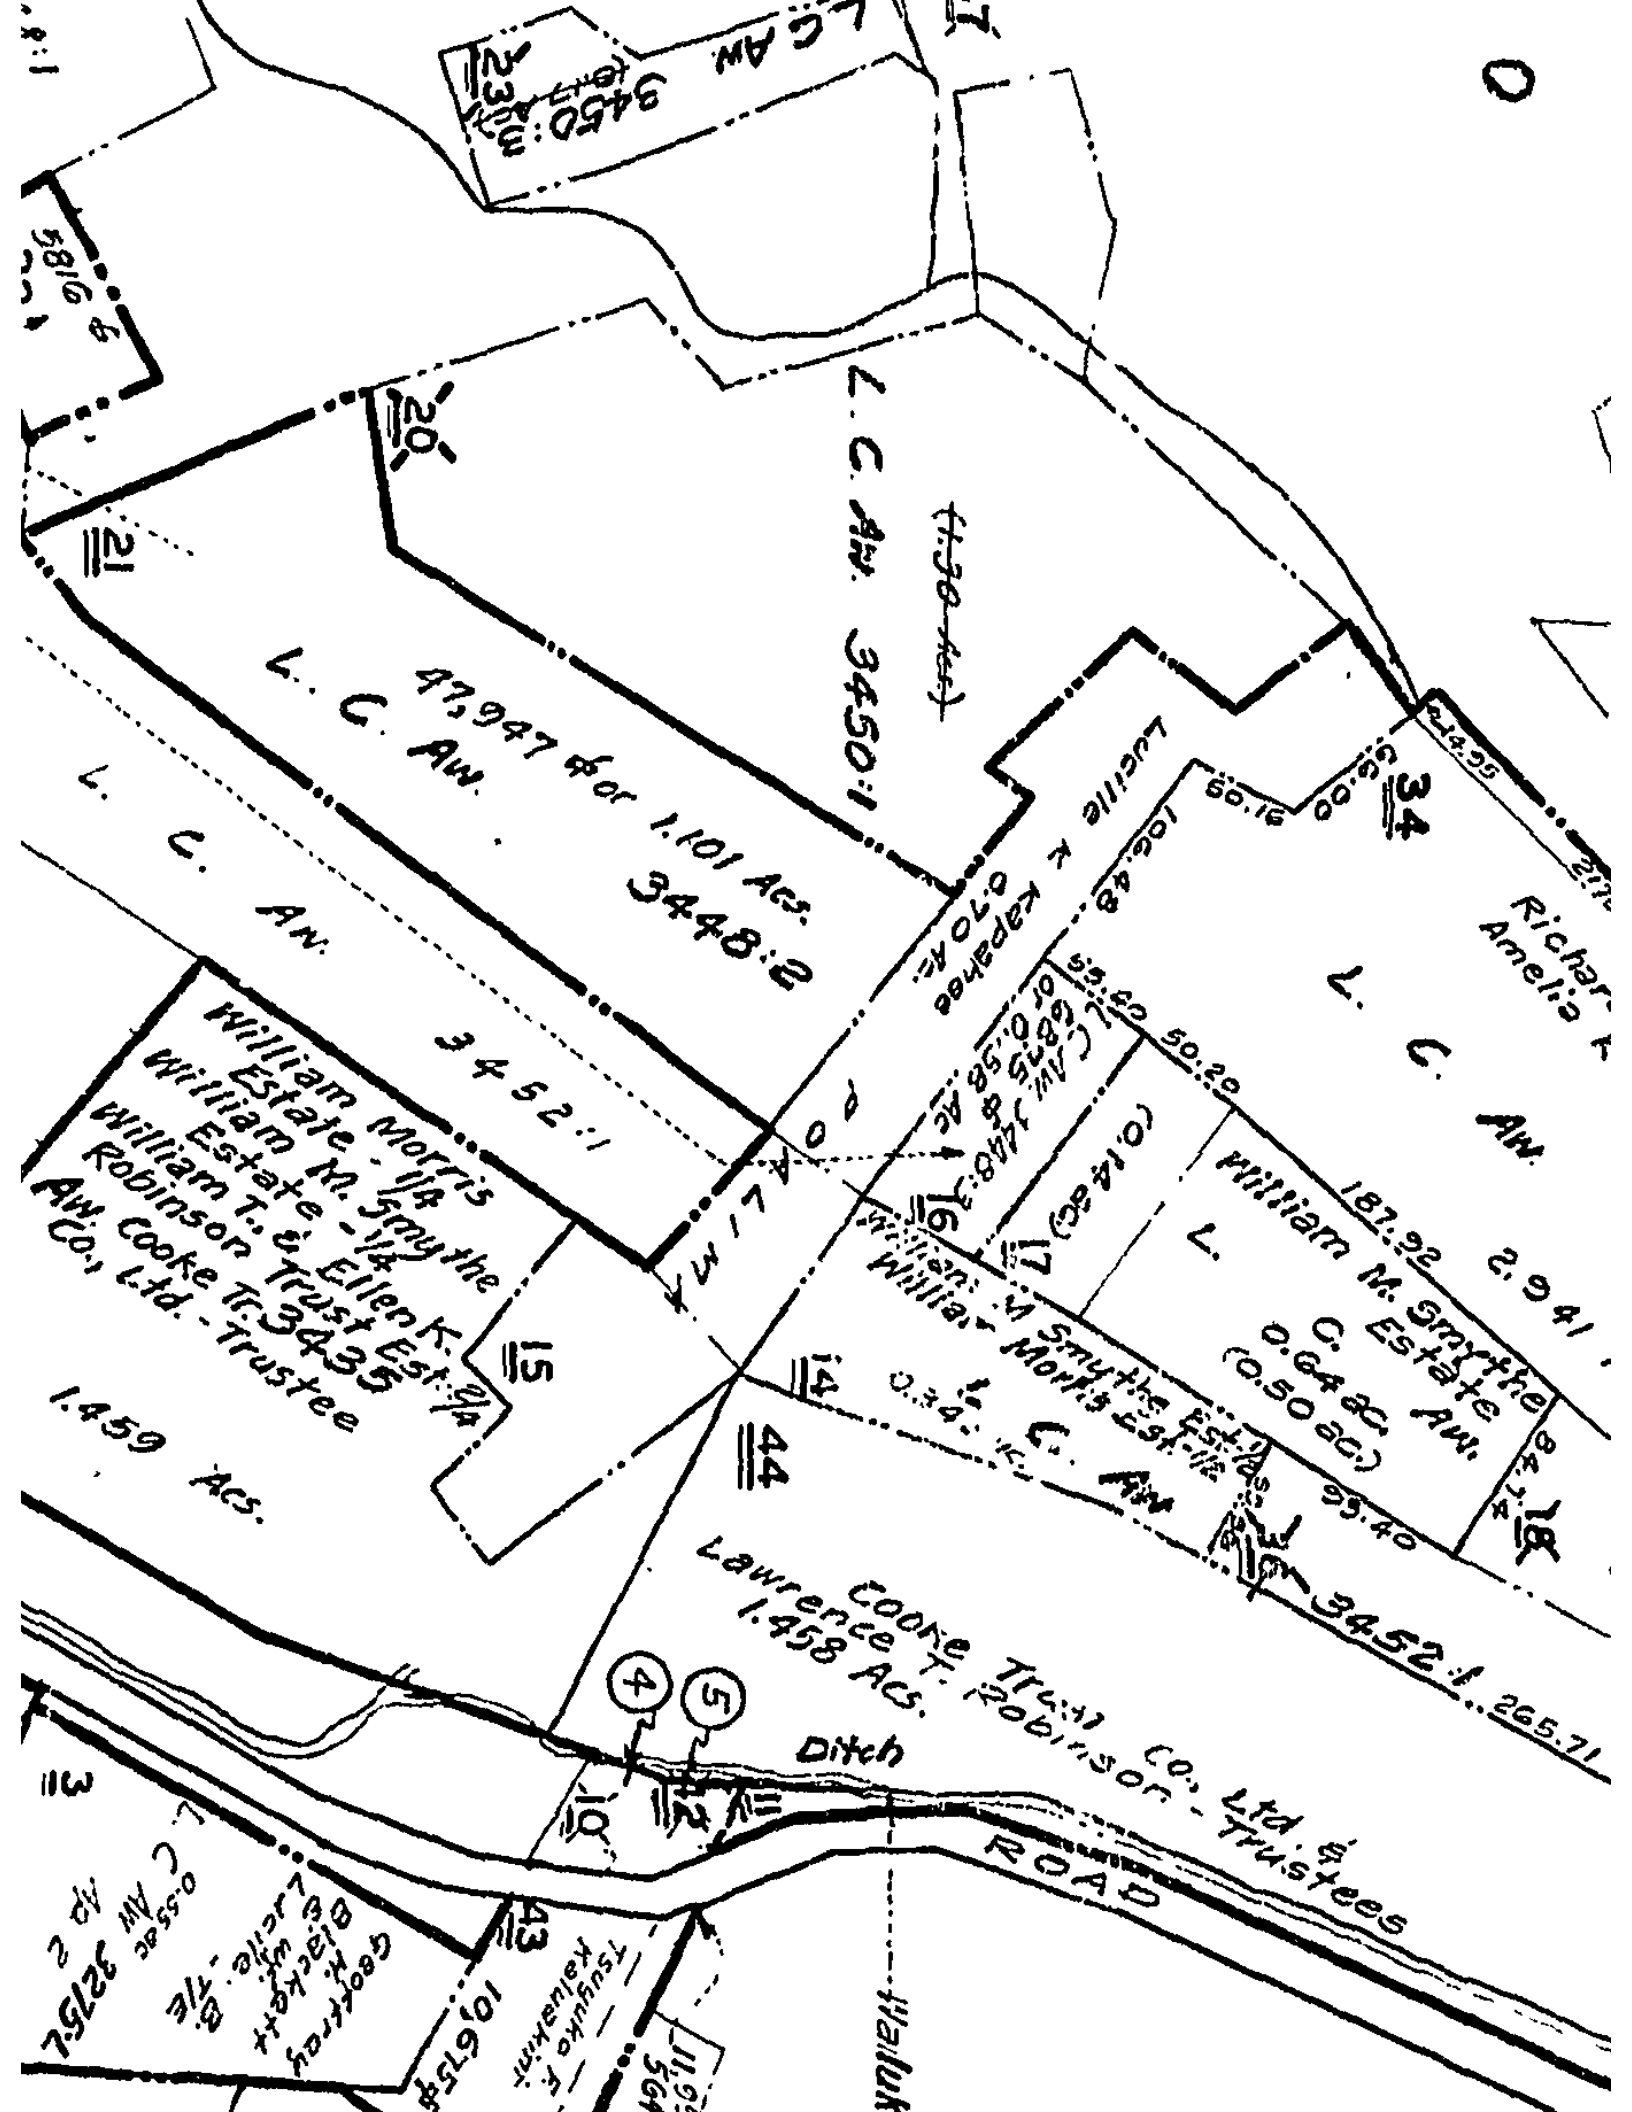

L. C. Aw. 3450:1
L. C. Aw. 3448:2
47,947 ⌀ or 1.101 Acs.
L. C. Aw. 3452:1
William Morris Estate - 1/4
William M. Smythe Estate - 1/4
William T. & Ellen K. Robinson Trust Est. 2/4
Aw. Cooke Tr. 3435 Co., Ltd. - Trustee
1.459 Acs.
Lucille K. Kapahee 0.70 Ac.
POALIMA
L. C. Aw. 3448:3 or 0.58 Ac.
William M. Smythe Estate
L. C. Aw. 0.64 ac. (0.50 ac.)
William M. Smythe Est. 1/2
William Morris Est. 1/2
L. C. Aw.
Richard Amelia K.
L. C. Aw.
Cooke Trust Co., Ltd. & Lawrence T. Robinson - Trustees
1.458 Acs.
Ditch
ROAD
3452:1
265.71
187.92
2,941
50.20
55.40
106.48
66.00
91.09
14.95
99.40
84.74
Tsuyuko F. Kaluakini
10,675 ⌀
Geoffrey H. Blackett & wf. Lucile - T/E
0.55 ac Ap 2
L. C. Aw. 3275:L

NORTH WAIEHU KULEANA LANDS			
DAYS	M.G.	TIME	KULEANAS
MONDAY	.037	4:00 P.M.-8:00 A.M.	1 – 14
TUESDAY	"	" "	1 – 14
WEDNESDAY	"	" "	1 – 14
THURSDAY	"	" "	1 – 14
FRIDAY	"	" "	1 – 14
SATURDAY	"	" "	1 – 14
SUNDAY	"	" "	1 – 14
DAILY FROM WHEE DITCH	.20±	24 hrs.	1

	SOUTH WAIEHU KULEANA LANDS					
	NAMES	AREAS				
KUL NO.	OWNERS	TARO	VEG.	HSE LOT	IDLE	TOTAL
1	W S Co ET AL			.25	1.00	1.25
2	V.K. MORI ETAL			10	.95	1.05
3	A. CARRILLO	1.94		.10	.90	2.94
4	A.B. KANOA ETAL	.50		10		.68
5	J CERIZO ETAL	.85	.10	.25		1.20
6	A. PALU	.21		.10		.31
7	M. OKAMURA		1.00	.15	.95	2.00
8	J KAHOOHALOHANO		.80	.50	2.08	3.38
9	F BALDWIN	.50	1.81	.20	3.80	6.01
10	R K AHNEE ET AL			.49	1.00	1.49
		4.08	3.41	2.14	10.68	20.305

	NORTH WAIEHU KULEANA LANDS					
	NAMES	AREAS				
KUL. NO	OWNERS	TARO	VEG.	HSE LOT	IDLE	TOTAL
1	NELLIE ALAU ESTATE	3.18		.25	.25	3.68
2	WM T. ROBINSON EST.	1.19			.20	1.39
~~3~~	~~A. KONTE K. KAHIO ESTATE~~				~~1.30~~	~~1.30~~
4	WM. T. ROBINSON EST	.70	.46	1.26		2.92
5	GEO. O KAPAHEE ESTATE	.50	.20			.70
6	IWA BETTS	1.50		1.042	2.50	5.04
7	WM. SMYTHE	.64				.64
8	" "	.34				.34
9	SARAH KAHALEKULU			1.01		1.01
10	NELLIE ALAU	.30		.55	.20	1.05
11	Y. EMOTO		1.86	.10		2.06
12	W TENGAN	.30	.10		.25	.65
13	W. HANO			.10	.45	.55
14	L KAWAKINI EST			.35		.35
15	H. KISHINOTO		.50	.27		.76
16	JOE WHITFORD ESTATE		.68	.61	.22	1.49
17	L.K. KAPAHEE ESTATE		7.01	2.00	.80	9.81
18	M. KUSHIYAMA			.20	.65	.85
~~19~~	~~T. SUGHIRA~~			~~.40~~		~~.14~~
19	D. KAAWA		.40	.54		.94
20	GEO KAHOLOKAI			.28	.40	.68
		8.65	11.73	9.00	~~6.92~~ 5.62	~~35.50~~ 34.59

1477 Ac.

1 – 10 ALL H C & S Co WATER
18 – 17 FROM WATER TUNNEL
17 – 20 " WAIEHU STREAM

15 – 21 WATER TUNNEL & LOWER INTAKE 13.678 ACRES.

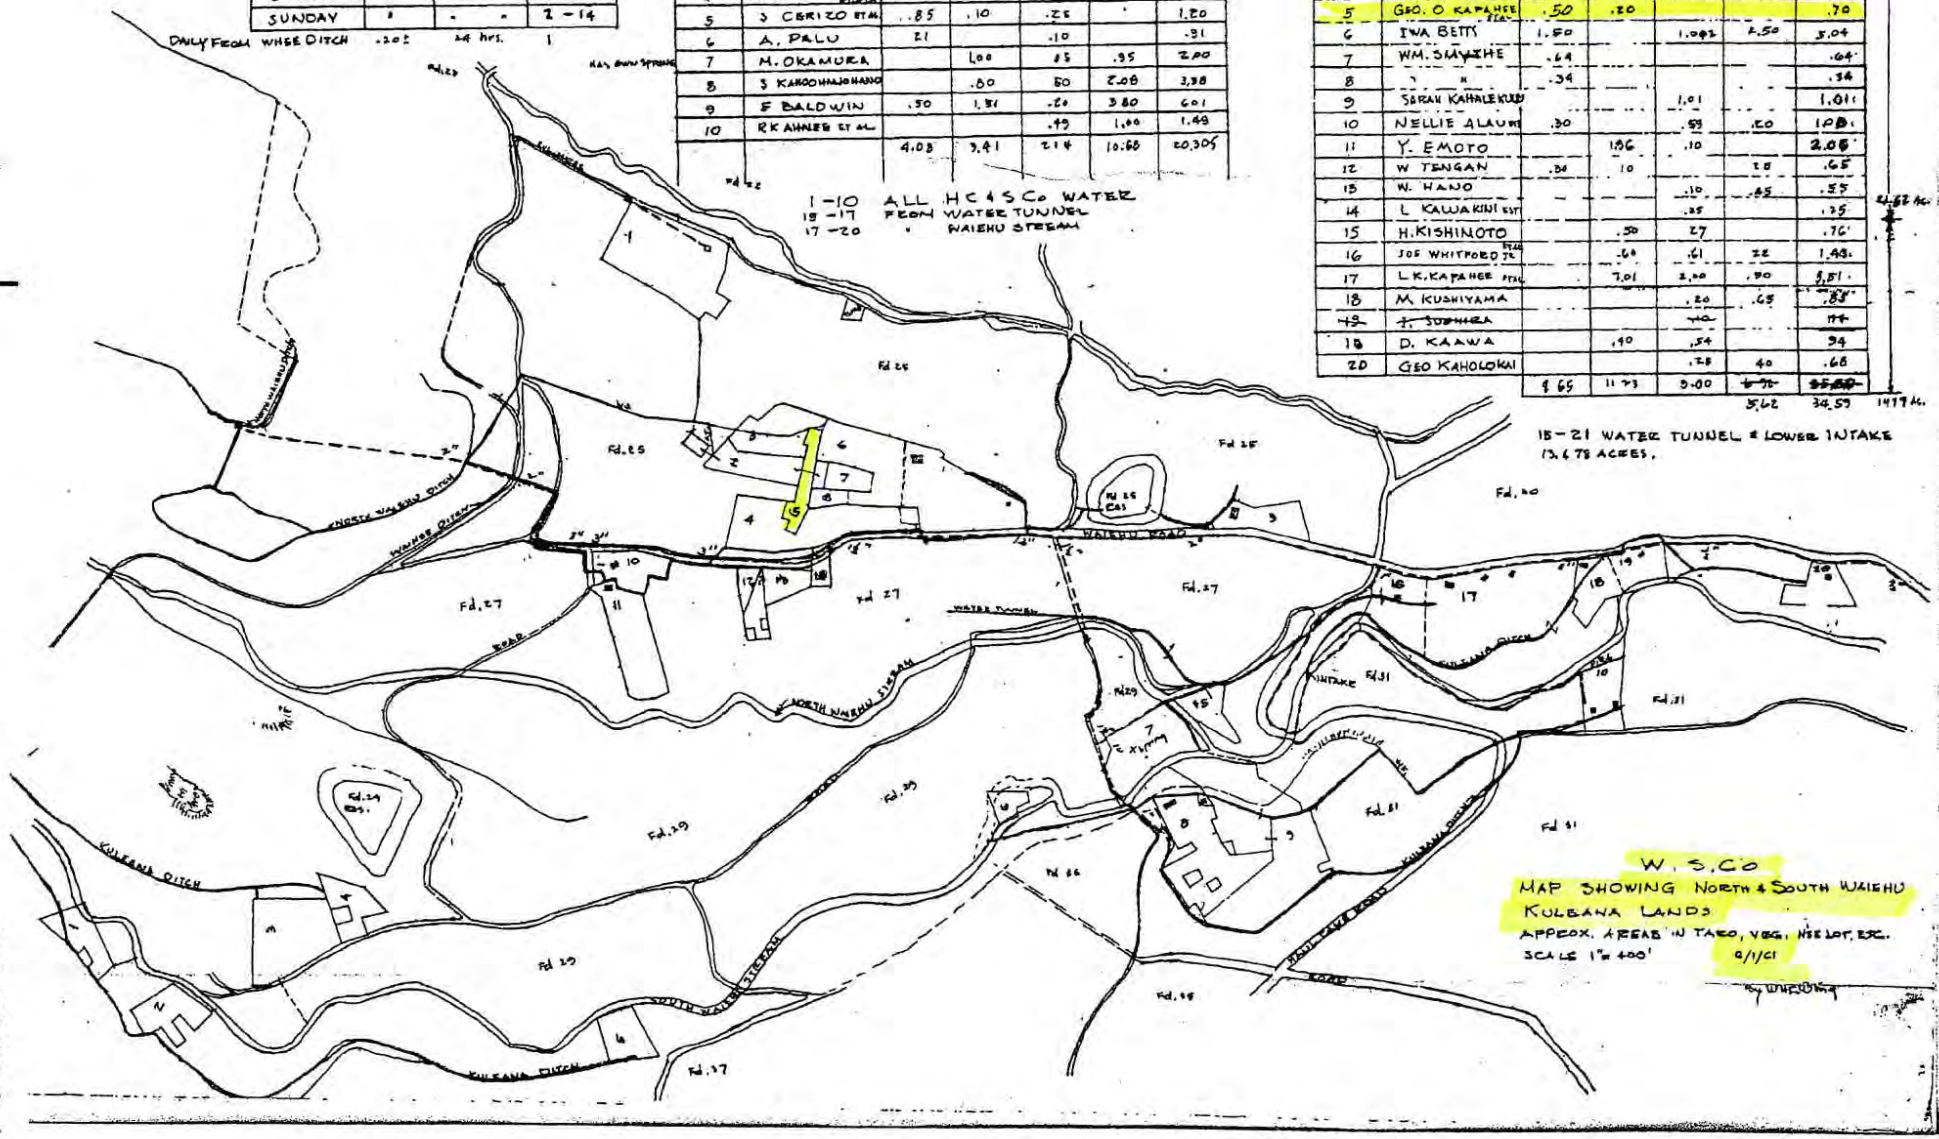

W. S. Co
MAP SHOWING NORTH & SOUTH WAIEHU KULEANA LANDS
APPROX. AREAS IN TARO, VEG, HSE LOT, ETC.
SCALE 1" = 400'
9/1/21